merritt PROPERTIES

COLUMBIA CORPORATE PARK

8850 STANFORD BLVD. COLUMBIA, MD 21045

SUITES 4500-4600

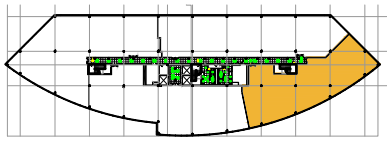

TOTAL SF AVAILABLE -5,372 RSF (16%)

Click to access **CADD file**

Key Plan



Floor Plan

PLAN NOT TO SCALE - THIS IS NOT A CONSTRUCTION DOCUMENT

DRAWING #: ZA1-4500-4600 ASBUILT DATE: **07.02.2026**